
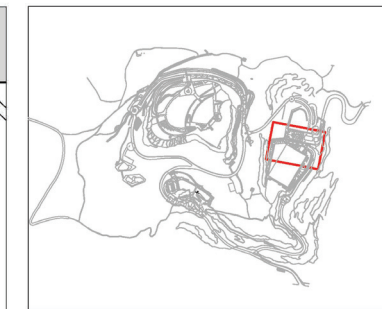


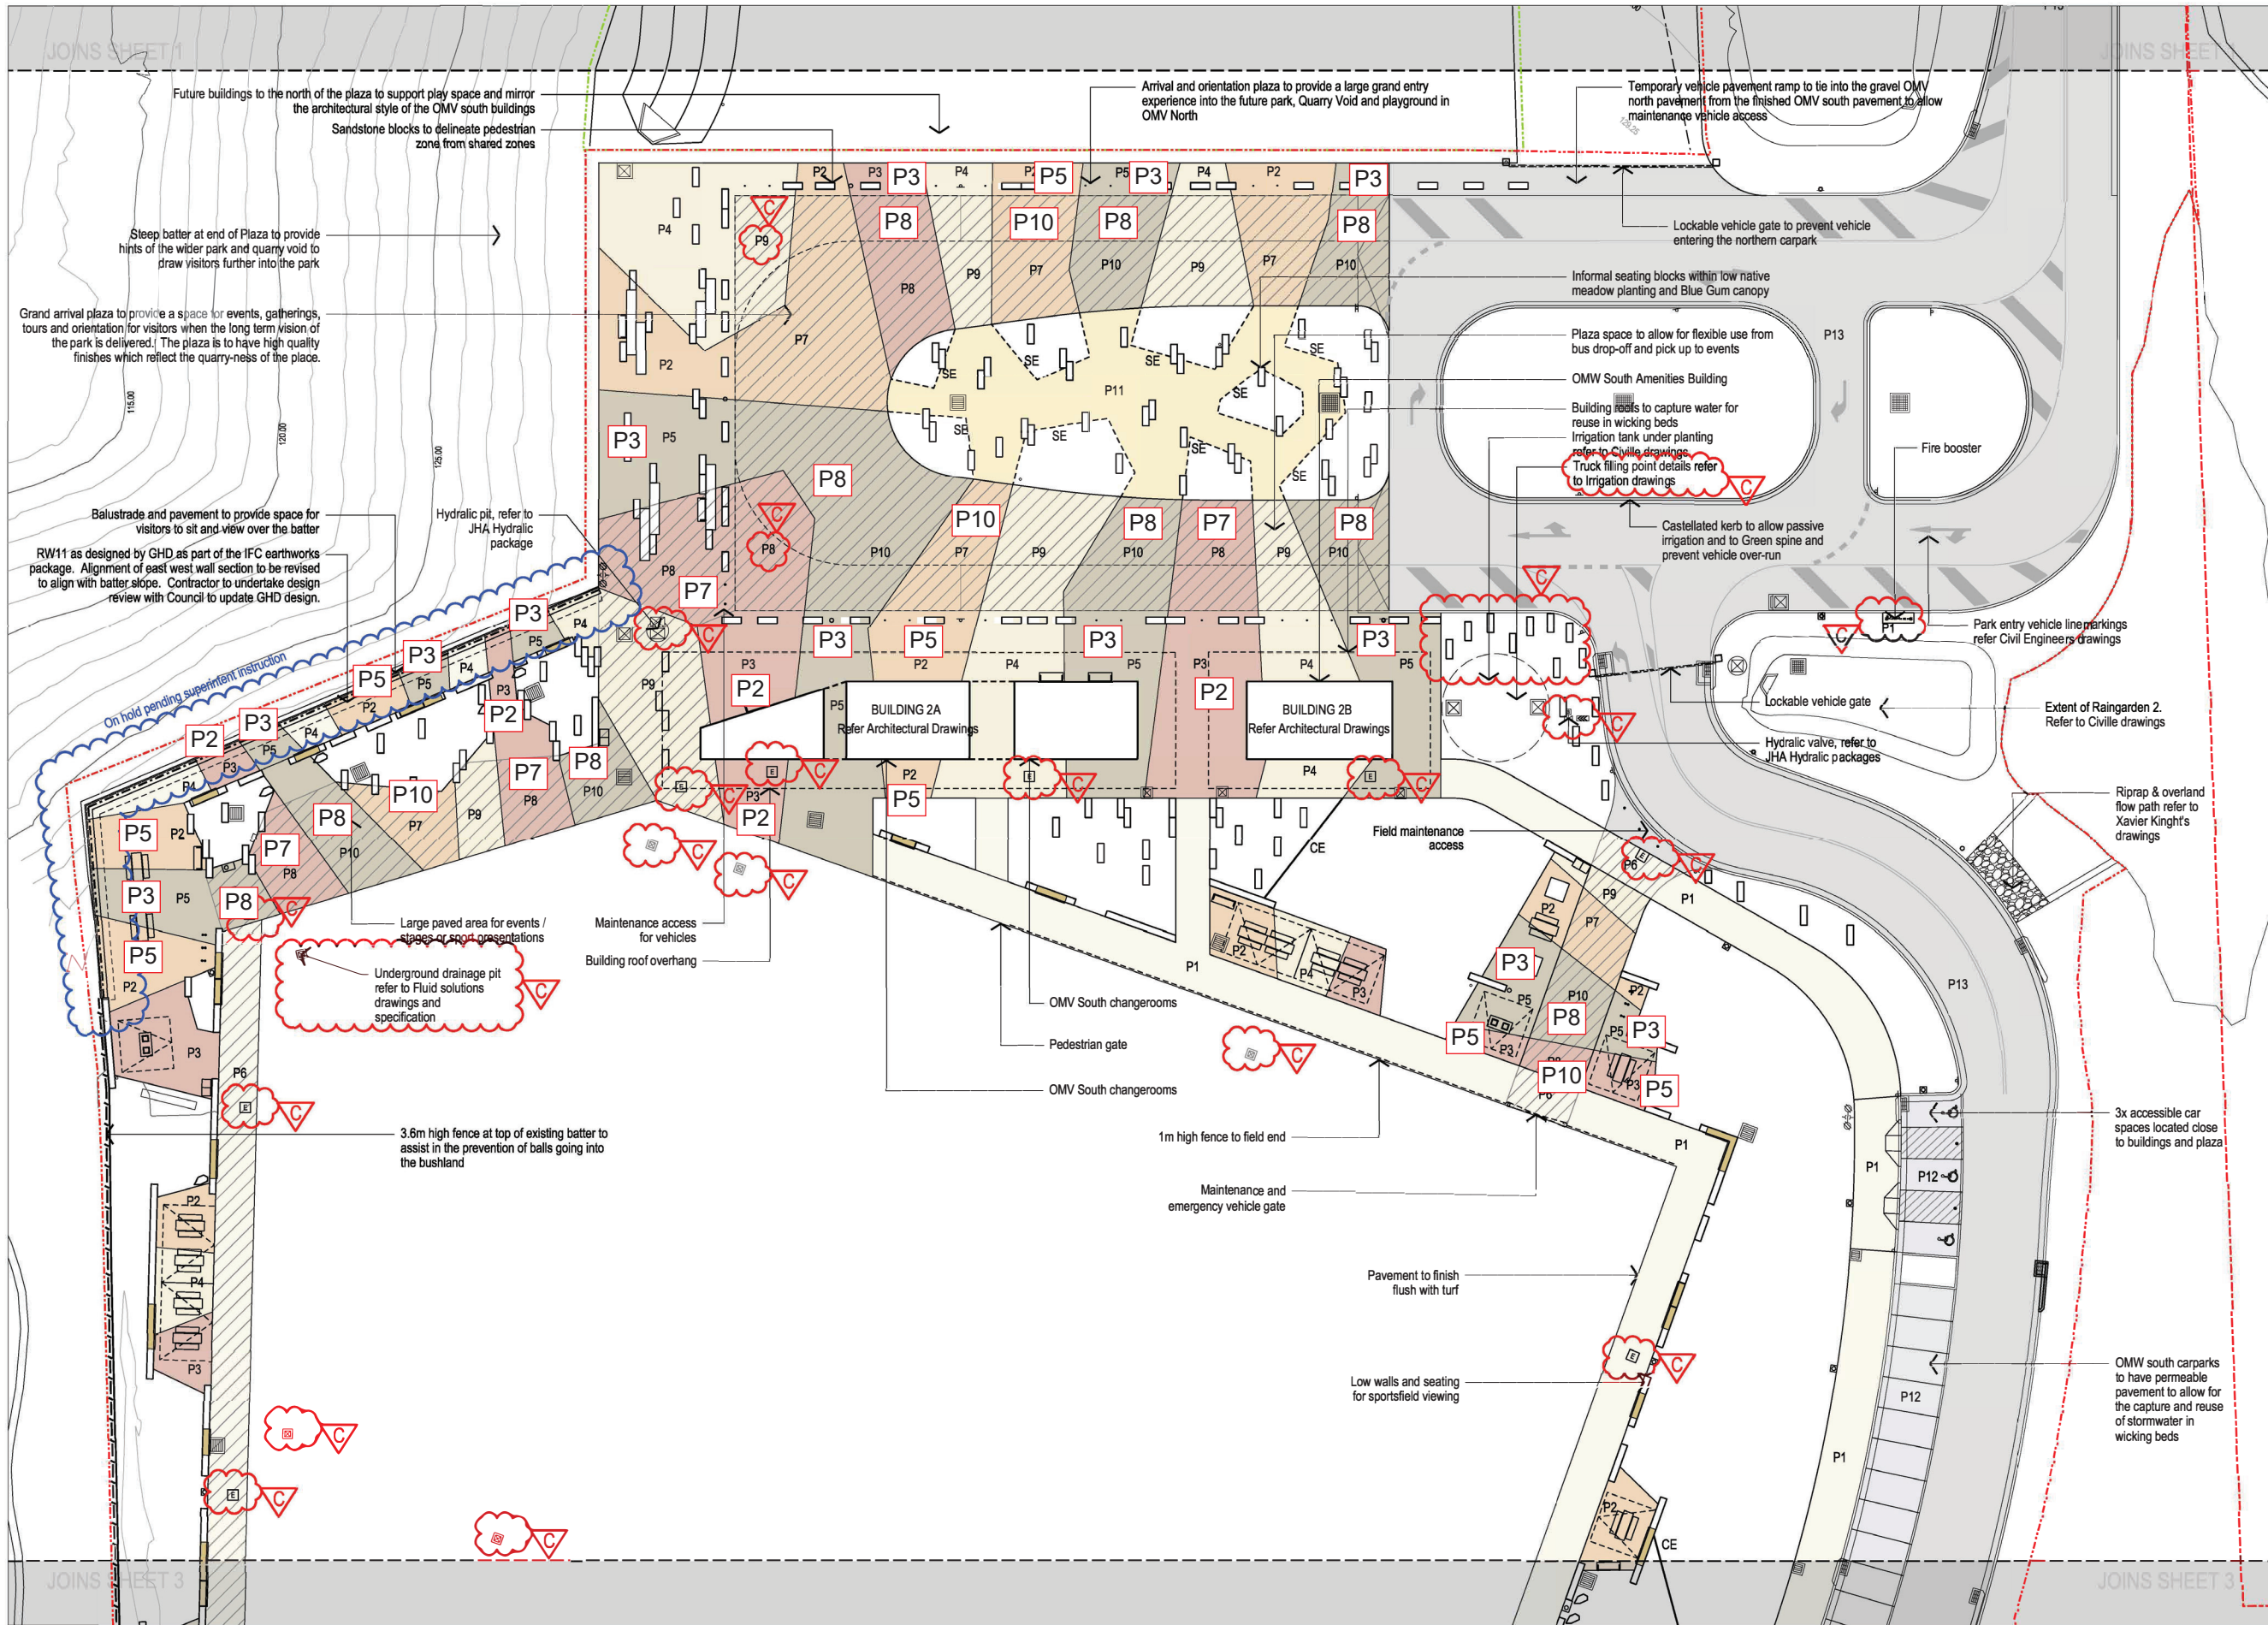

KEY PLAN

LEGEND

- Site Boundary
- OMV South extent of work
- OMV North temporary landscape works
- Fire Trail upgrade extent of work
- Extended platform area for future bike facilities
- Paving type 1 - Standard concrete
- Paving type 2 - Exposed aggregate concrete
- Paving type 3 - Coloured concrete - Basalt
- Paving type 4 - Coloured concrete - Sandstone
- Paving type 5 - Exposed aggregate concrete
- Paving type 6 - Vehicular standard concrete
- Paving type 7 - Vehicular exposed aggregate concrete
- Paving type 8 - Vehicular coloured concrete - Basalt
- Paving type 9 - Vehicular coloured concrete - Sandstone
- Paving type 10 - Vehicular exposed aggregate concrete
- Paving type 11 - Permeable paving
- Paving type 12 - Vehicular permeable car parking
- Paving type 13 - Vehicular asphaltic concrete
- Paving type 14 - FRP decking
- Existing sandstone outcrop on site to remain
- Tactile indicators
- Stormwater infrastructure
- Field drainage pits
- Hydraulic pit and valve
- Concrete edge
- Steel edge
- Electrical pits
- Main Switchboard
- Electrical distribution board

NOTE: Contractor is to use Service Enhancement Contractor as built drawings and survey for services to ensure there are no clashes between Service Enhancement services and Field of Play services

NOTE: This document is Preliminary unless Verified and is for planning purposes only

REV	REVISION DESCRIPTION	REVISION DATE	REVIEW	VERIFY	VALIDATE
C	ISSUE FOR CONSTRUCTION	18.02.2026	BH	AR	JH
B	90% ISSUE FOR TENDER	17.09.2025	BH	AR	
A	WIP DRAFT TENDER ISSUE	04.09.2025	BH	AR	

CLIENT
HORNSBY SHIRE COUNCIL

266 PEATS FERRY ROAD
HORNSBY, NSW 2077

hsc@hornsby.nsw.gov.au
02 9847 6666

LEAD CONSULTANT
CLOUSTON associates
A DIVISION OF
BEVERIDGE WILLIAMS

65-69 KENT STREET
SYDNEY NSW 2000
EMAIL: sydney@clouston.com.au
TELEPHONE: (02) 8272 4999

CONCRETE PAVING FINISHES PLAN

REVISED FINISHES LAYOUT

25 MARCH 2026

HORNSBY SHIRE COUNCIL

PROJECT HORNSBY PARK EMBELLISHMENT WORK
OLD MANS VALLEY SOUTH LANDSCAPE WORKS

DRAWING TITLE
OMV SOUTH HARDWORKS PLAN SHEET 2 OF 3

CLIENT
HSC

DRAWN
BH

DRAWING NUMBER
HPE_TEN_LA_OMV_30.02

SCALE
1:250@A1

REVISION
C

0 2.5 5 7.5 10 12.5 25m

NORTH